


LEGEND

1. Trash compactor
2. Sink with disposal
3. Dishwasher
4. Refrigeration space
5. Freezer space
6. Cook top stove w/ WASH BASIN
7. Double sink w/ disposal
8. Pantry/storage
9. Sink


SEE SHT # P.2 FOR
FIXTURE SCHEDULE

NOTE: FIXTURE #9 SHALL
BE LENN. DELUXE
MODEL 2-125 BLACK

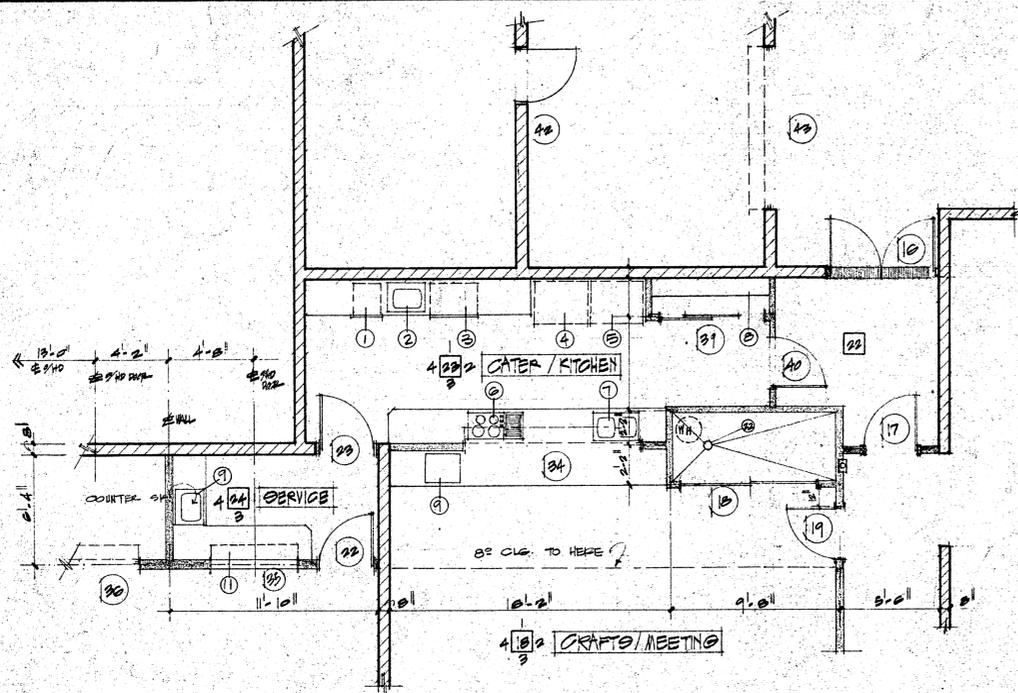

PARTIAL PLAN KITCHEN/SERVICES 1/4" = 1'-0"


All fixtures, hardware, entry/exits, etc. must comply with 1973 U.B.C., Chapter 17, Table 33A and Chapter 33 regulations and City and County of Los Angeles, State of California minimum requirements for the physically handicapped. It is to be the contractor's strict responsibility to comply with these regulations. The architect is to be informed immediately of any discrepancies that may occur on these documents.

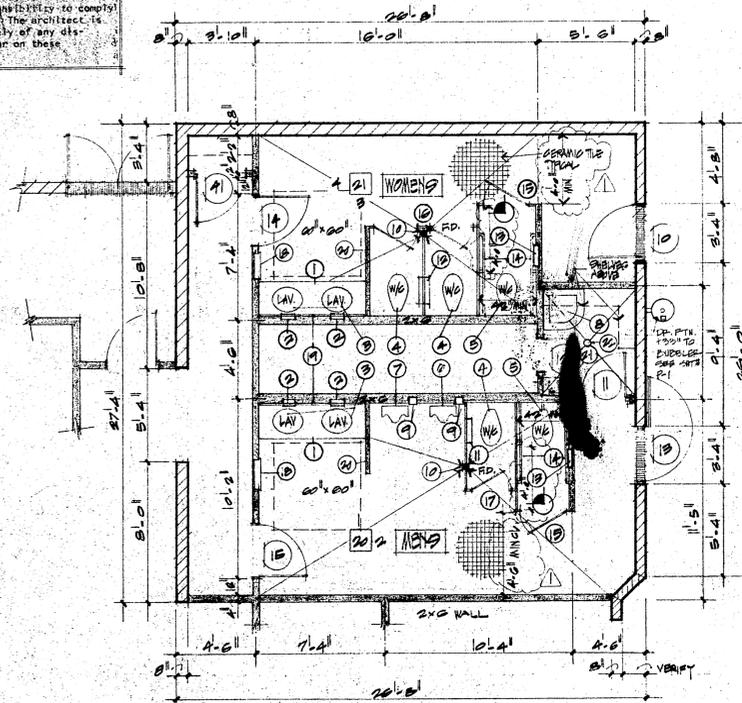


PARTIAL PLAN RESTROOMS 1/4" = 1'-0"

LEGEND


1. Plastic laminated top and splash.
2. All ~~plastic~~ dispensers (recessed).
3. Lavatory.
4. Wall mounted water closet.
5. Handicap model wall mounted water closet.
6. Handicap type wall hung urinal.
7. Wall hung urinal.
8. Floor mounted service sink.
9. ~~Handicap~~ ash urn.
10. Floor drain (slope floor to drain).
11. PARTITION AND SEAT COVER DISP. & TOILET TISSUE DISP. SERVES (2) COMPART.
12. Partition mounted seat cover dispenser, napkin disposal, toilet tissue dispenser serving two (2) compartments.
13. ~~Handicap~~ toilet seat cover dispenser, napkin disposal, toilet tissue dispenser handicap compartment, serves (1) compartment.
14. GRAB BARS 48" LONG.
15. Plastic laminated toilet partition compartment for handicap.
16. Plastic laminated toilet compartment serving (2) stalls.
17. As per #16 serving (1) stall.
18. recessed paper towel dispenser and waste receptacle.
19. 1/4" polish plate w/ 1/4" glass mirror.
20. 2x4 flat studs with ceramic tile over gyp board.

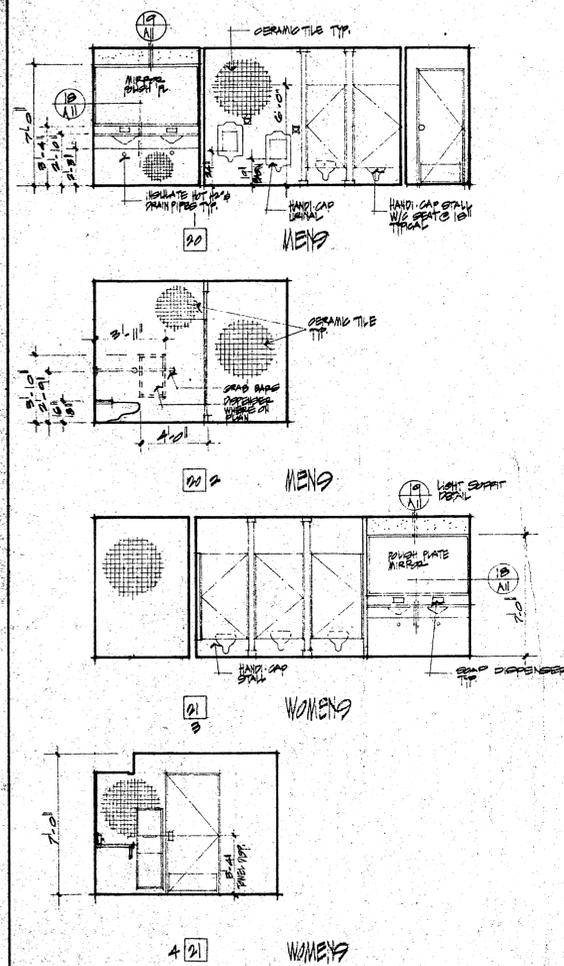


ELEVATIONS OF RESTROOMS 1/4" = 1'-0"

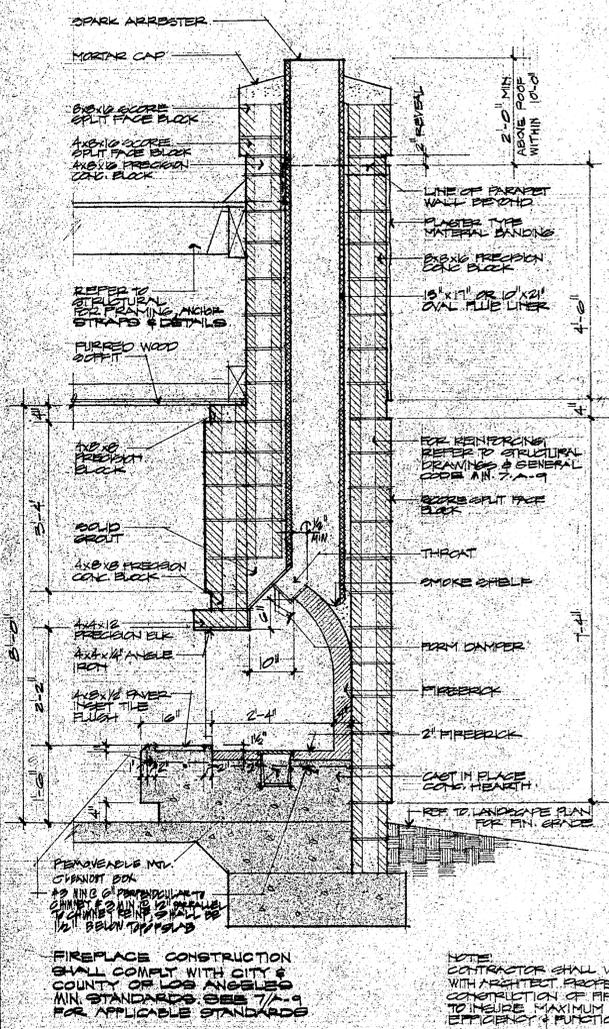

FIREPLACE SECTION 3/4" = 1'-0"

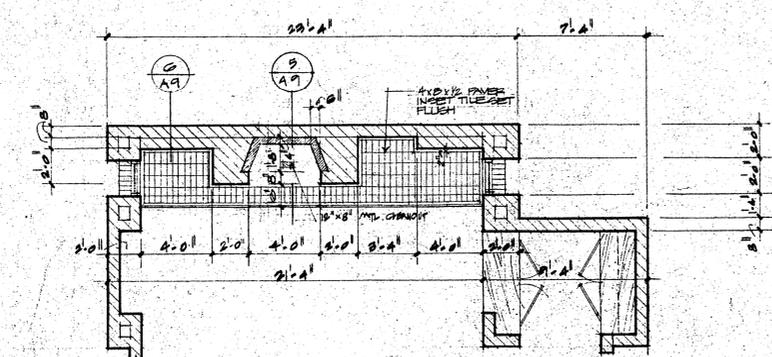

PARTIAL PLAN GYMNASIUM 1/4" = 1'-0"

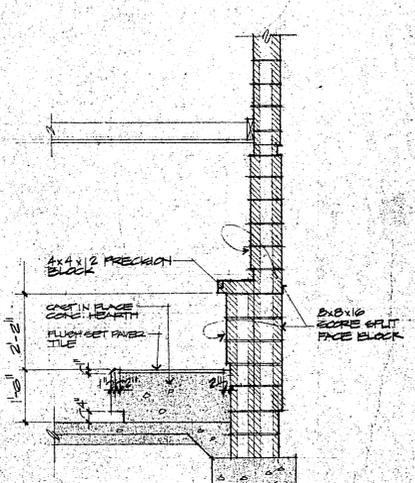

SECTION 1/2" = 1'-0"

EXPLANATION

NO.	DESCRIPTION	DATE	BY	CHKD.
1	ADD 1/4" POLISH PLATE W/ 1/4" GLASS MIRROR	1/25/82
2	ADD 2x4 FLAT STUDS WITH CERAMIC TILE OVER GYP BOARD	1/25/82
3	ADD 1/4" POLISH PLATE W/ 1/4" GLASS MIRROR	1/25/82
4	ADD 2x4 FLAT STUDS WITH CERAMIC TILE OVER GYP BOARD	1/25/82
5	ADD 1/4" POLISH PLATE W/ 1/4" GLASS MIRROR	1/25/82
6	ADD 2x4 FLAT STUDS WITH CERAMIC TILE OVER GYP BOARD	1/25/82
7	ADD 1/4" POLISH PLATE W/ 1/4" GLASS MIRROR	1/25/82
8	ADD 2x4 FLAT STUDS WITH CERAMIC TILE OVER GYP BOARD	1/25/82
9	ADD 1/4" POLISH PLATE W/ 1/4" GLASS MIRROR	1/25/82
10	ADD 2x4 FLAT STUDS WITH CERAMIC TILE OVER GYP BOARD	1/25/82
11	ADD 1/4" POLISH PLATE W/ 1/4" GLASS MIRROR	1/25/82
12	ADD 2x4 FLAT STUDS WITH CERAMIC TILE OVER GYP BOARD	1/25/82
13	ADD 1/4" POLISH PLATE W/ 1/4" GLASS MIRROR	1/25/82
14	ADD 2x4 FLAT STUDS WITH CERAMIC TILE OVER GYP BOARD	1/25/82
15	ADD 1/4" POLISH PLATE W/ 1/4" GLASS MIRROR	1/25/82
16	ADD 2x4 FLAT STUDS WITH CERAMIC TILE OVER GYP BOARD	1/25/82
17	ADD 1/4" POLISH PLATE W/ 1/4" GLASS MIRROR	1/25/82
18	ADD 2x4 FLAT STUDS WITH CERAMIC TILE OVER GYP BOARD	1/25/82
19	ADD 1/4" POLISH PLATE W/ 1/4" GLASS MIRROR	1/25/82
20	ADD 2x4 FLAT STUDS WITH CERAMIC TILE OVER GYP BOARD	1/25/82

IF PLACE MINIMUM CONCT. REQUIREMENT FOR FIREPLACE 1/2" = 1'-0"